


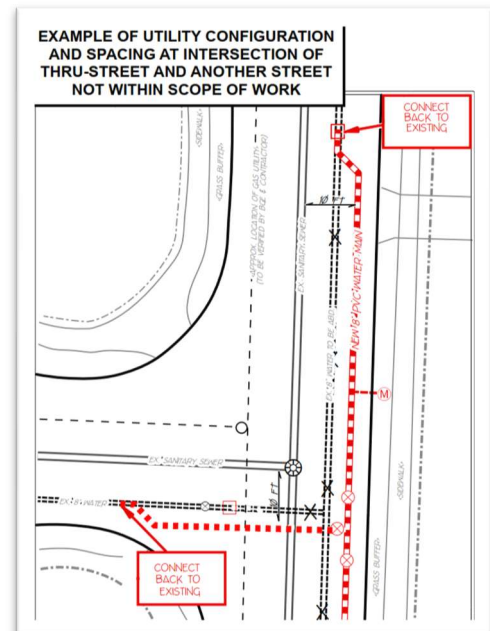

ADDENDUM NO. 3 (cont.)

**BID NO. 26-02
ABERDEEN HILLS WATERLINE**

Q2: Please confirm the two (2) inch galvanized water line to be abandoned does not get filled with grout.

A2: No, the 2" galvanized water line does not need to be filled with grout for abandonment. Also, it is worth noting that the 2" galvanized lines are often fed by a manifold of 2 to 4 smaller taps into the larger supplying main.

Q3: Back to the pavement patching. Plate R-4 calls for a minimum of nine inches of asphalt. Plate R-5 calls for a minimum of 5.5 inches. Please confirm wherever R-5 is used only 5.5 inches or to match existing will be required.

A3: Wherever existing pavement is thicker than what the detail calls for, match the existing pavement thickness.

Q4: Can you clarify the full scope of bid item 006 for Engineering Services and what exactly the city wants the contractor to cover?

A4: Engineering services cover all test pitting, field verification, surveying, measuring, utility markouts, etc. within the awarded exhibits. The contractor is expected to perform these verifications and provide a summary of findings to the City before construction begins. This summary shall include a marked up version of the concept drawings that reflects the actual location/depth of utilities and any conflicts or revisions resulting from field verifications and test pitting.

From SPG – 7.1.1: Project Drawings: The Contractor shall provide markup of concept drawings for City approval after conducting all field verifications, test pits, and site surveys. Once approved by the City, the revised concept drawings shall be the basis for work conducted within the scope of the project.

Q5: Is there any way to delay the bid date by a week or so?

A5: The bid opening date shall remain as scheduled: October 1, 2025 at 1:00pm.